RECORD OF SURVEY OF BOUNDARY LINE ADJUSTMENT

FOR

THE MAXEY FAMILY TRUST 605-O.R.-113

SCALE: 1" = 200'

STAN G. OVERWESER

BEING A PORTION OF SECTION 6, T.7N., R.13E., M.D.M.
COUNTY OF AMADOR, STATE OF CALIFRNIA

JUNE, 1992

Toma & Anderson
Licensed Land Surveyors
41 Summit Street
Jackson, California
(209) 223-0156

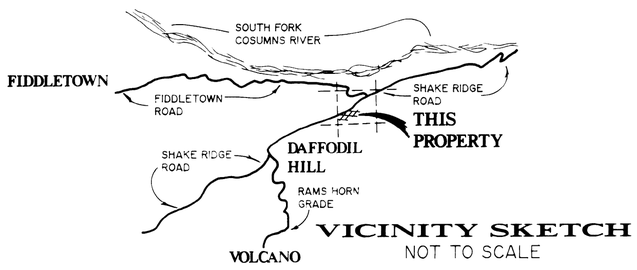

VICINITY SKETCH
NOT TO SCALE

NOTES and LEGEND

- ● DENOTES 3/4" REBAR TAGGED L.S. 3570 AND SET ON THIS SURVEY.
- ⌀ DENOTES IRON PIPE TAGGED L.S. 3570 AND FOUND ON THIS SURVEY.
- ⌀ DENOTES 5/8" REBAR TAGGED L.S. 3570 AND FOUND ON THIS SURVEY.
- ○ DENOTES A MATHEMATICAL POINT ONLY, NOTHING FOUND OR SET
- ⊙ DENOTES 3/4" REBAR TAGGED L.S. 3570 AND FOUND ON THIS SURVEY.

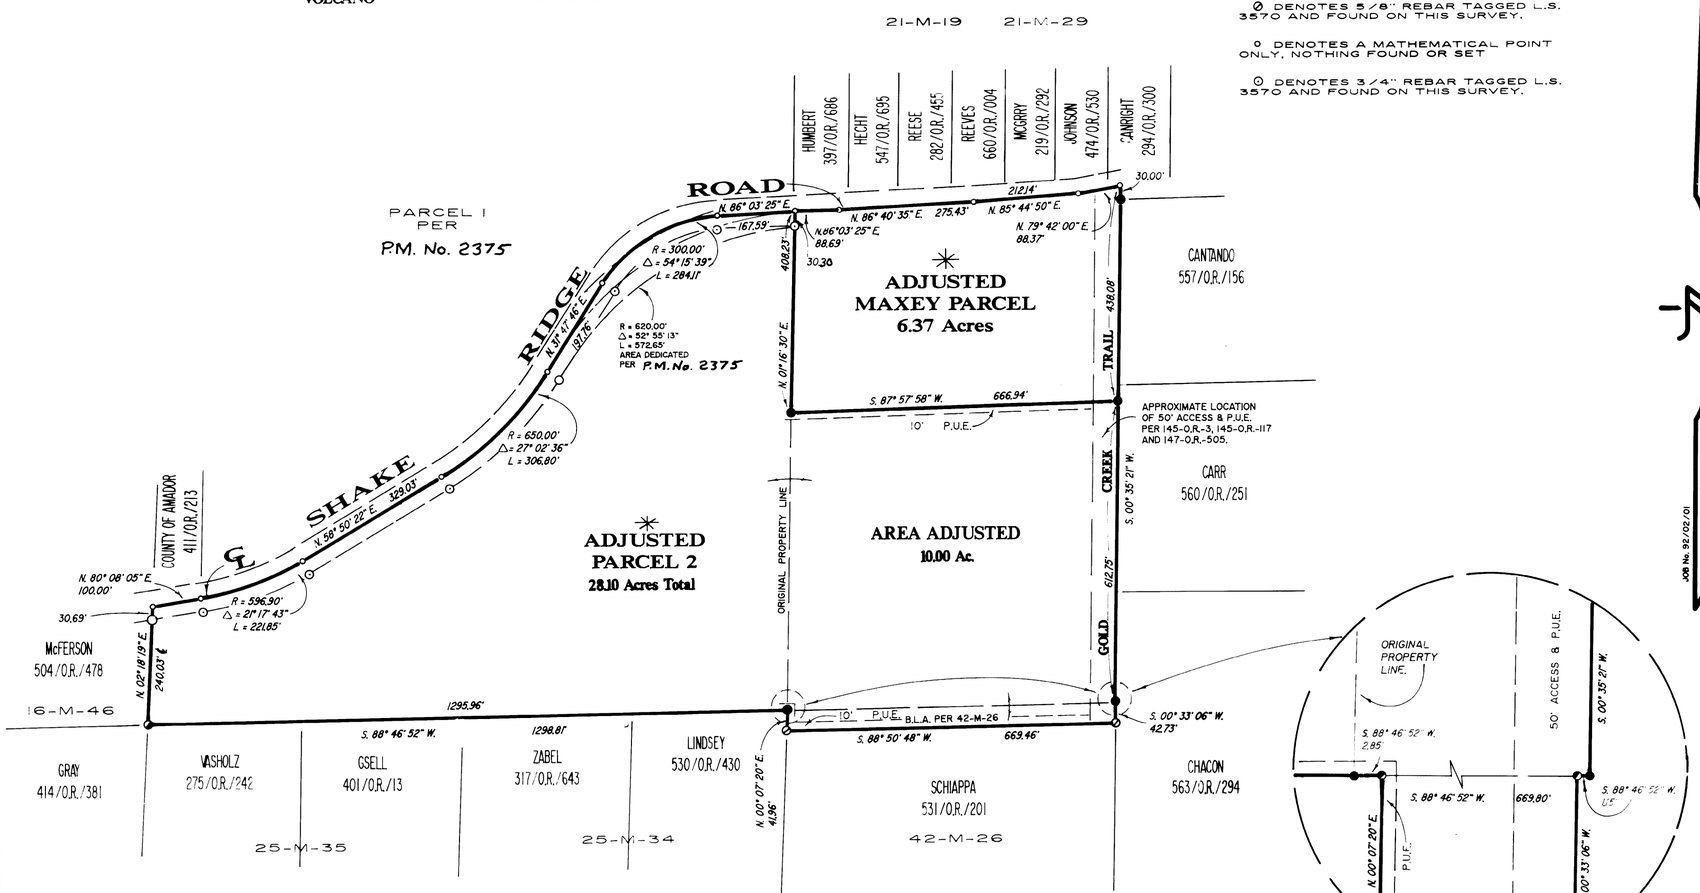

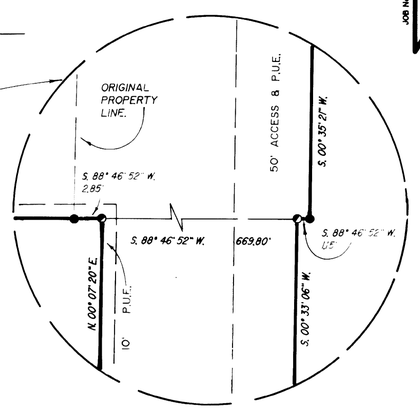

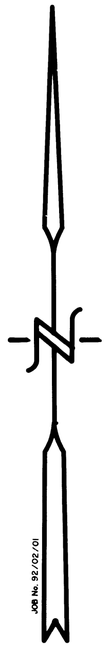

SURVEYOR'S STATEMENT

THIS MAP CORRECTLY REPRESENTS A SURVEY MADE BY ME, OR UNDER MY DIRECTION IN CONFORMANCE WITH THE REQUIREMENTS OF THE LAND SURVEYORS' ACT AT THE REQUEST OF: MAXEY FAMILY TRUST

CIRO L. TOMA L.S. 3570
MY LICENSE EXPIRES 6/30/92

LICENSED LAND SURVEYOR CIRO L. TOMA L.S. 3570 State of California

COUNTY SURVEYOR'S STATEMENT

THIS MAP HAS BEEN EXAMINED IN ACCORDANCE WITH SECTION 8766 OF THE LAND SURVEYORS' ACT THIS 15 DAY OF April 1993

C. LEE DE LANGE L.S. 4066
AMADOR COUNTY DEPUTY SURVEYOR
MY LICENSE EXPIRES 6/30/96

LICENSED LAND SURVEYOR C. LEE DE LANGE No. 4066 STATE OF CALIFORNIA

RECORDER'S STATEMENT

FILED THIS 1st DAY OF June 1993 AT 3:20 P.M. IN BOOK 47 OF MAPS AND PLATS AT PAGE 55 AT THE REQUEST OF THE AMADOR COUNTY DEPUTY SURVEYOR.
FEE: 7.00 paid 1993-005402

SHELDON D. JOHNSON
AMADOR COUNTY RECORDER
BY: Marlena Reese DEPUTY

✳NOTE

FINAL APPROVAL OF THIS MAP IS SUBJECT TO BOARD OF SUPERVISORS RESOLUTION No. 93-203 RECORDED IN ~~BOOK~~ OF OFFICIAL RECORDS AT ~~PAGE~~ THIS 29th DAY OF April 1993.
Instr. # 1993004196

OWNER'S STATEMENT

THE UNDERSIGNED BEING THE OWNER('S) OF THE PROPERTY DELINEATED HEREON DO HEREBY CONSENT TO THE PREPARATION AND RECORDATION OF THIS MAP.

W. A. Maxey

47M55